



9 ELEVENTH FLOOR PLAN


6.2 SCALE: 1/16" = 1'-0"

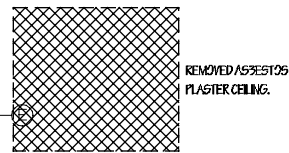

LEGEND

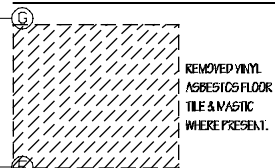


NOTE:
REMOVED ASBESTOS FIREPROOFING
OVERSPRAY FROM PIPING IN TOILET
CHASES.

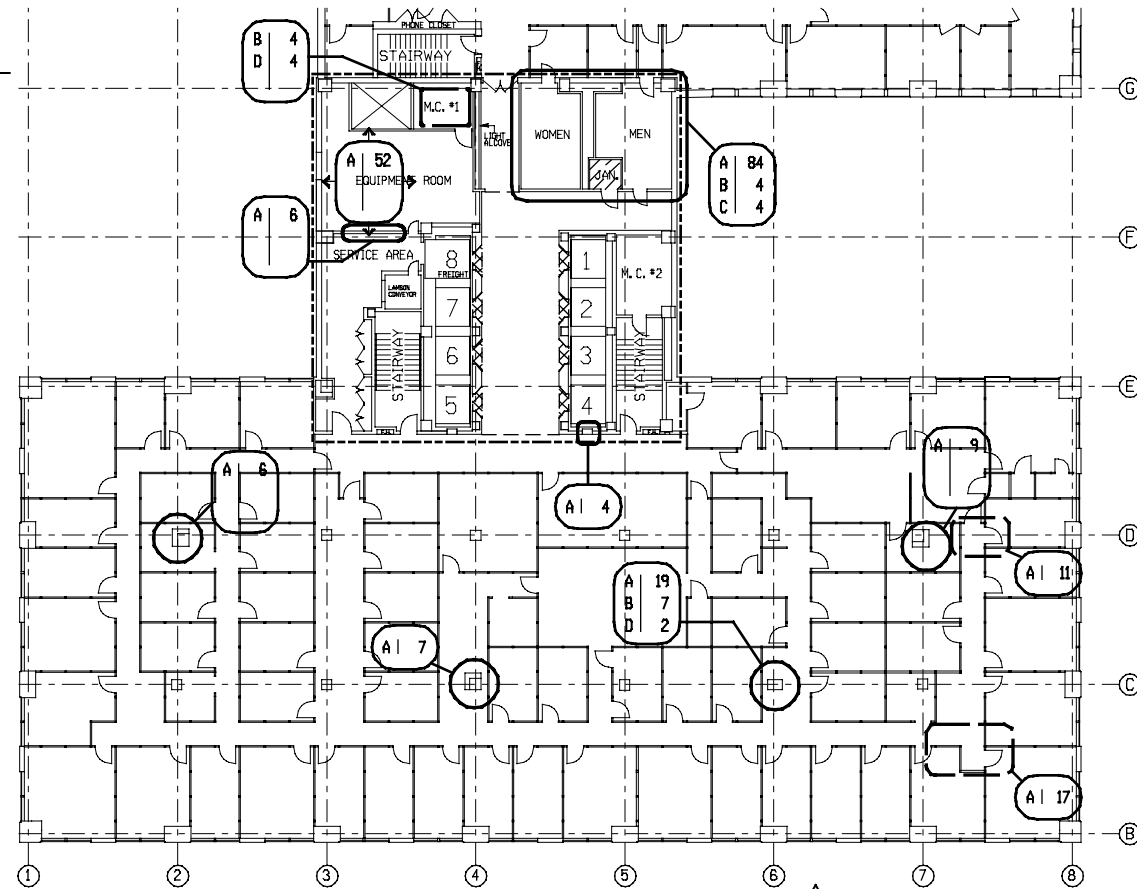


11 THIRTEENTH FLOOR PLAN

6.2 SCALE: 1/16" = 1'-0"

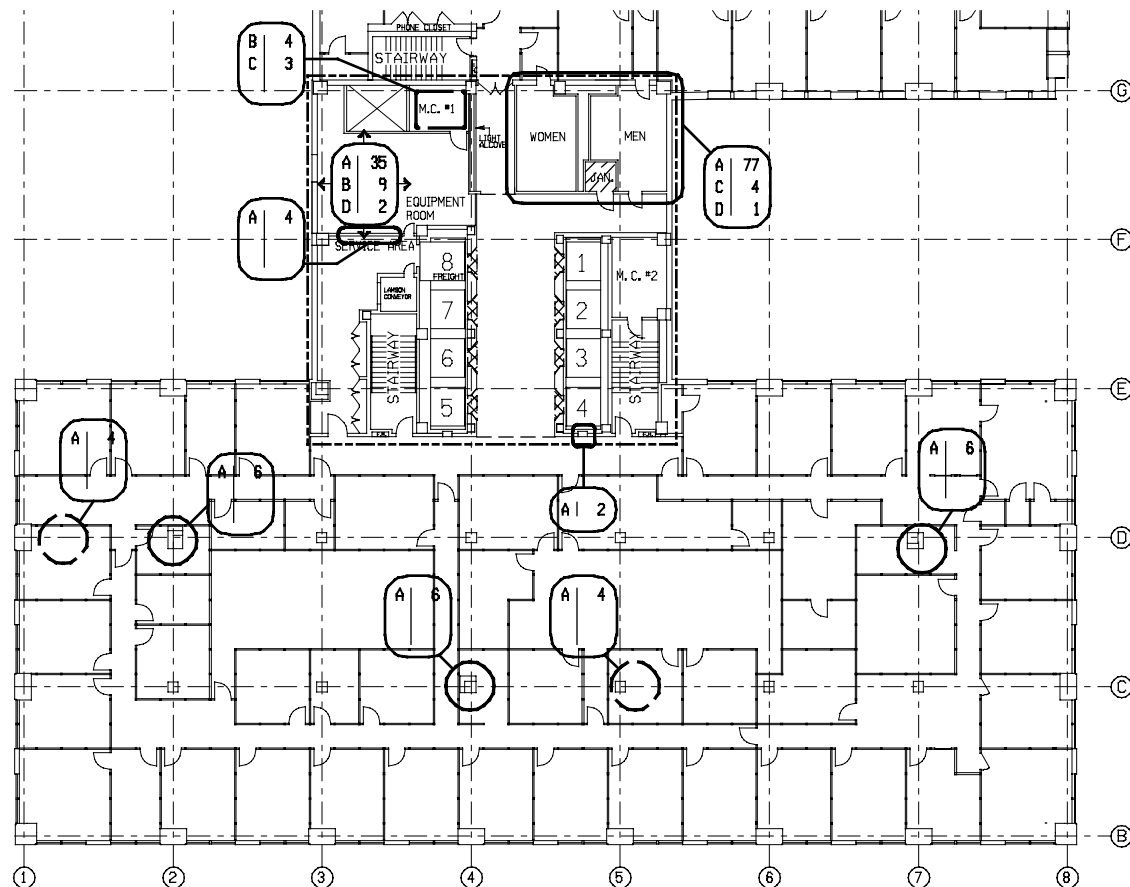

10 TWELFTH FLOOR PLAN

6.2 SCALE: 1/16" = 1'-0"

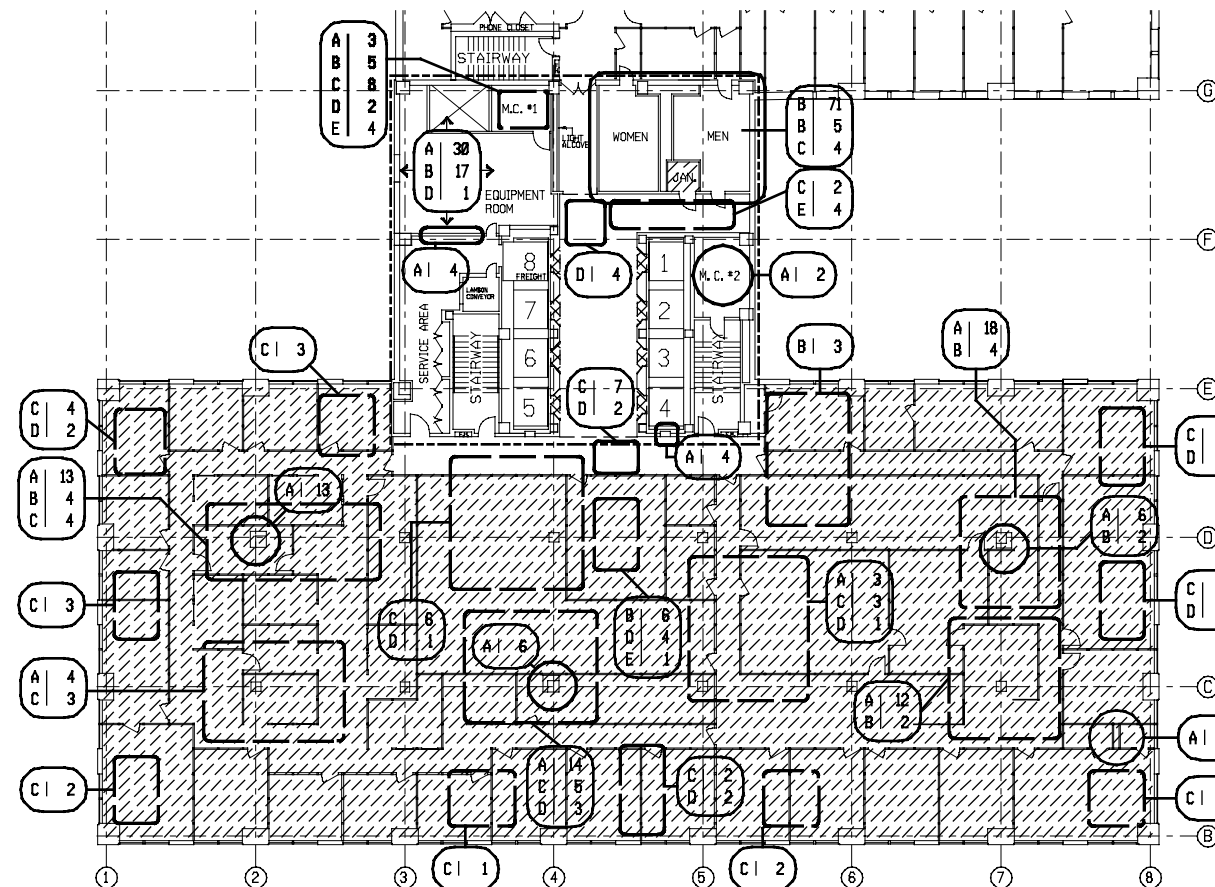

12 FOURTEENTH FLOOR PLAN

6.2 SCALE: 1/16" = 1'-0"



Morrison & Associates
Environmental Design and Management, Inc.
Norman, OK 73089
501 Alpine Circle
405/360-6625
FAX 405/321-0517

ASBESTOS ABATEMENT
TEXACO OFFICE BUILDING
TEXACO, INC.
1437 S. BOULDER - TULSA, OKLAHOMA

ELEVENTH -
FOURTEENTH

FLOOR PLANS

Drawn By: KFW

Checked By: JMM

Project Number: 9501.00

Issue Date: August 15, 1997

Revisions:
Asbestos Removal Record

Sheet No:

A6.2